

ANY MODIFICATIONS TO THIS DRAWING
SHALL BE IN COMPLIANCE WITH THE TEXAS
BOARD OF EXAMINERS RULES.

OZ CABIN

JOSH 06/05/2028

STARK DESIGN STUDIO

5715 PERSHING AVENUE, FORT WORTH, TX 76107
214.734.8036 V


ASHTON STARK - SITE 410

73 7 1127N1 C6C 73 C2

214. / 34.8036 V
http://www.starkdesignstudio.com
josh@starkdesignstudio.com

1 OF 2

1ST FLOOR
AS-BUILT

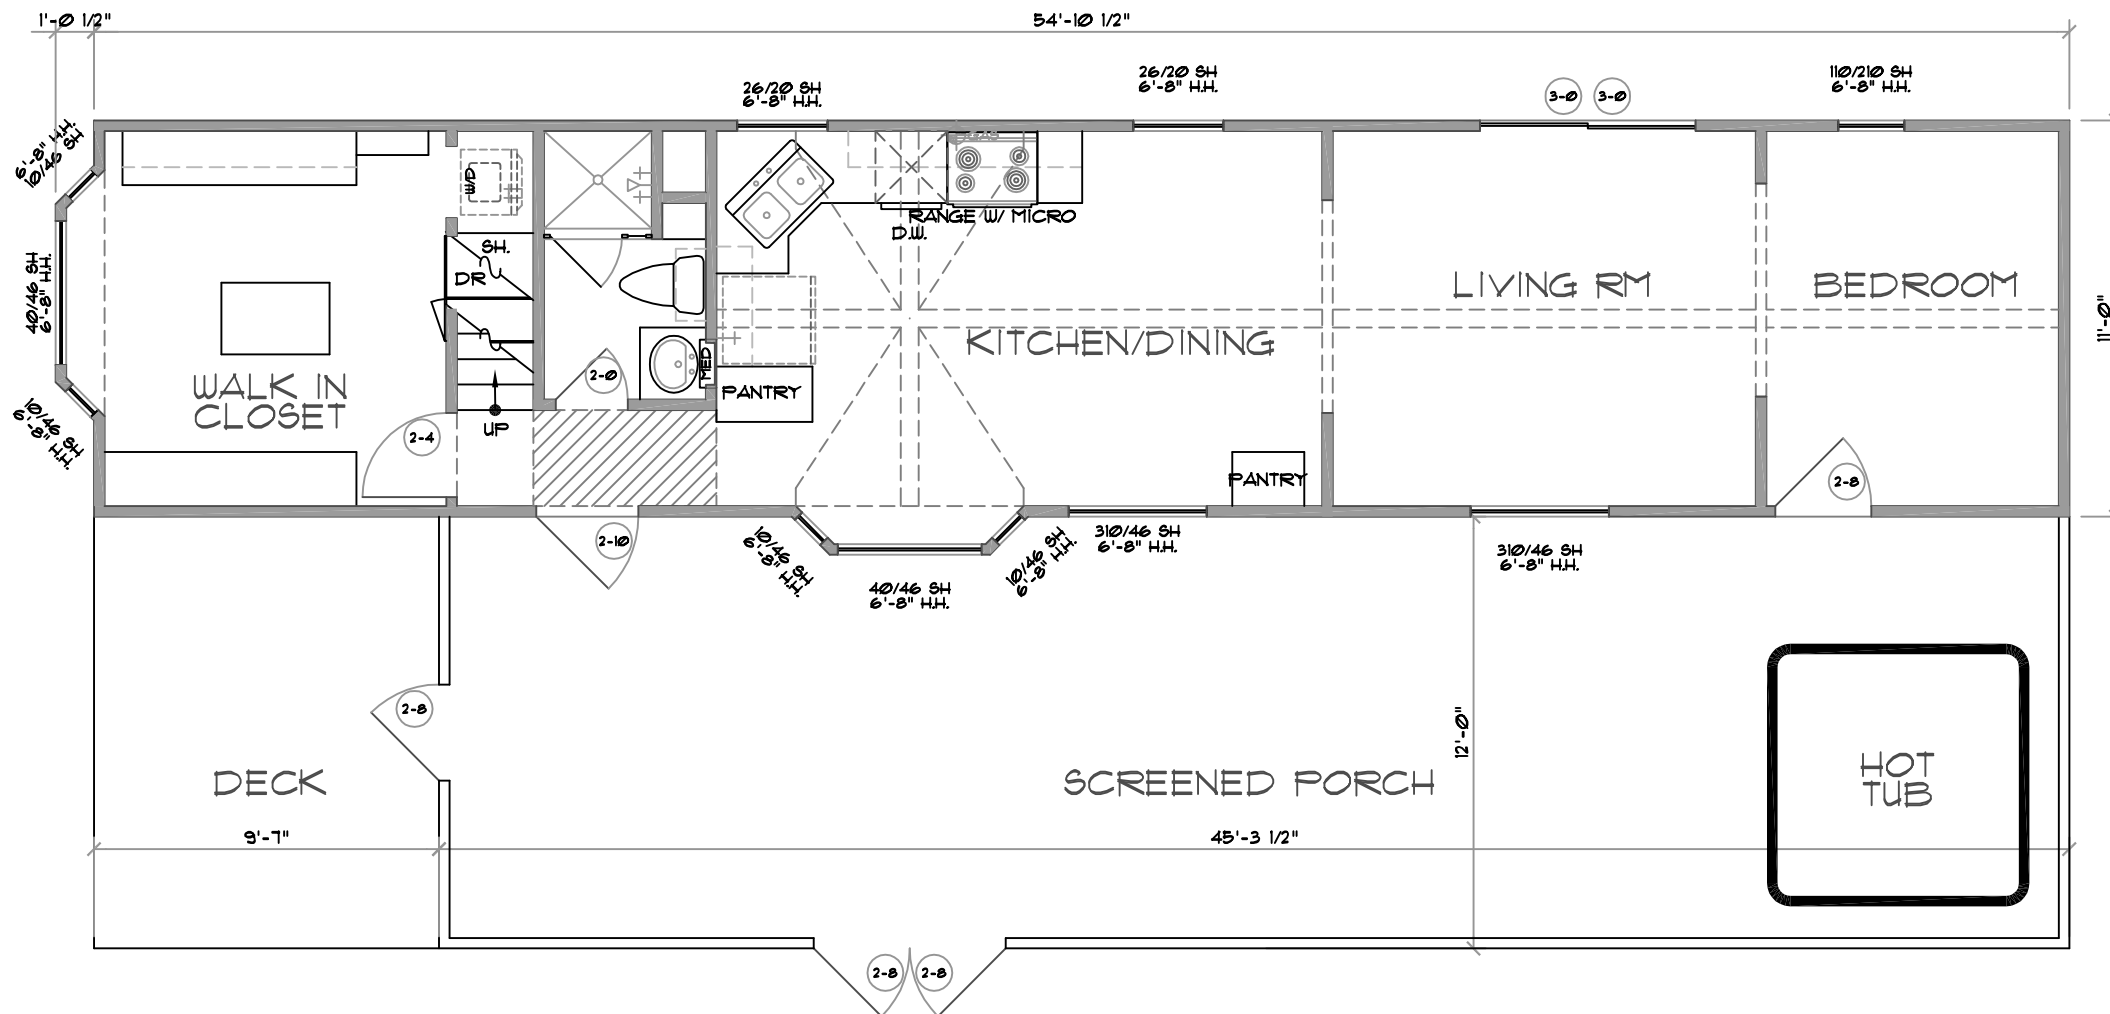

OZ - SITE 410 - AS-BUILT 1ST FLOORPLAN

1/4" n'l'-0"

SITE 410		
1ST FLOOR	616	SF.
2ND FLOOR	172	SF.
TOTAL A/C	788	SF.
SCREENED PORCH	544	SF.
TOTAL UNDER ROOF	1,332	SF.
DECK	115	SF.

THE RECORD COPY OF THIS DRAWING IS ON
FILE AT THE OFFICE OF STARK DESIGN
STUDIO, L.L.C., FORT WORTH, TEXAS. THIS
ELECTRONIC DOCUMENT IS RELEASED FOR THE
PURPOSES OF REFERENCE, COORDINATION,
AND OR FACILITY MANAGEMENT UNDER THE
AUTHORITY OF J. STARK, CH.
ANY MODIFICATIONS TO THIS DRAWING
SHALL BE IN COMPLIANCE WITH THE TEXAS
BOARD OF EXAMINERS' RULES.
©2020 STARK DESIGN STUDIO, L.L.C.

OZ CABIN

JOSH 06/08/2023

STARK DESIGN STUDIO

5715 PERSHING AVENUE, FORT WORTH, TX 76107
214.734.8036 V
<http://www.starkdesignstudio.com>
josh@starkdesignstudio.com


ASHTON STARK - SITE 410

50 6A 200 INADILLA 6A

2 OF 2

2ND FLOOR
AS-BUILT

26/20 SH 26/20 FG 26/20 SH

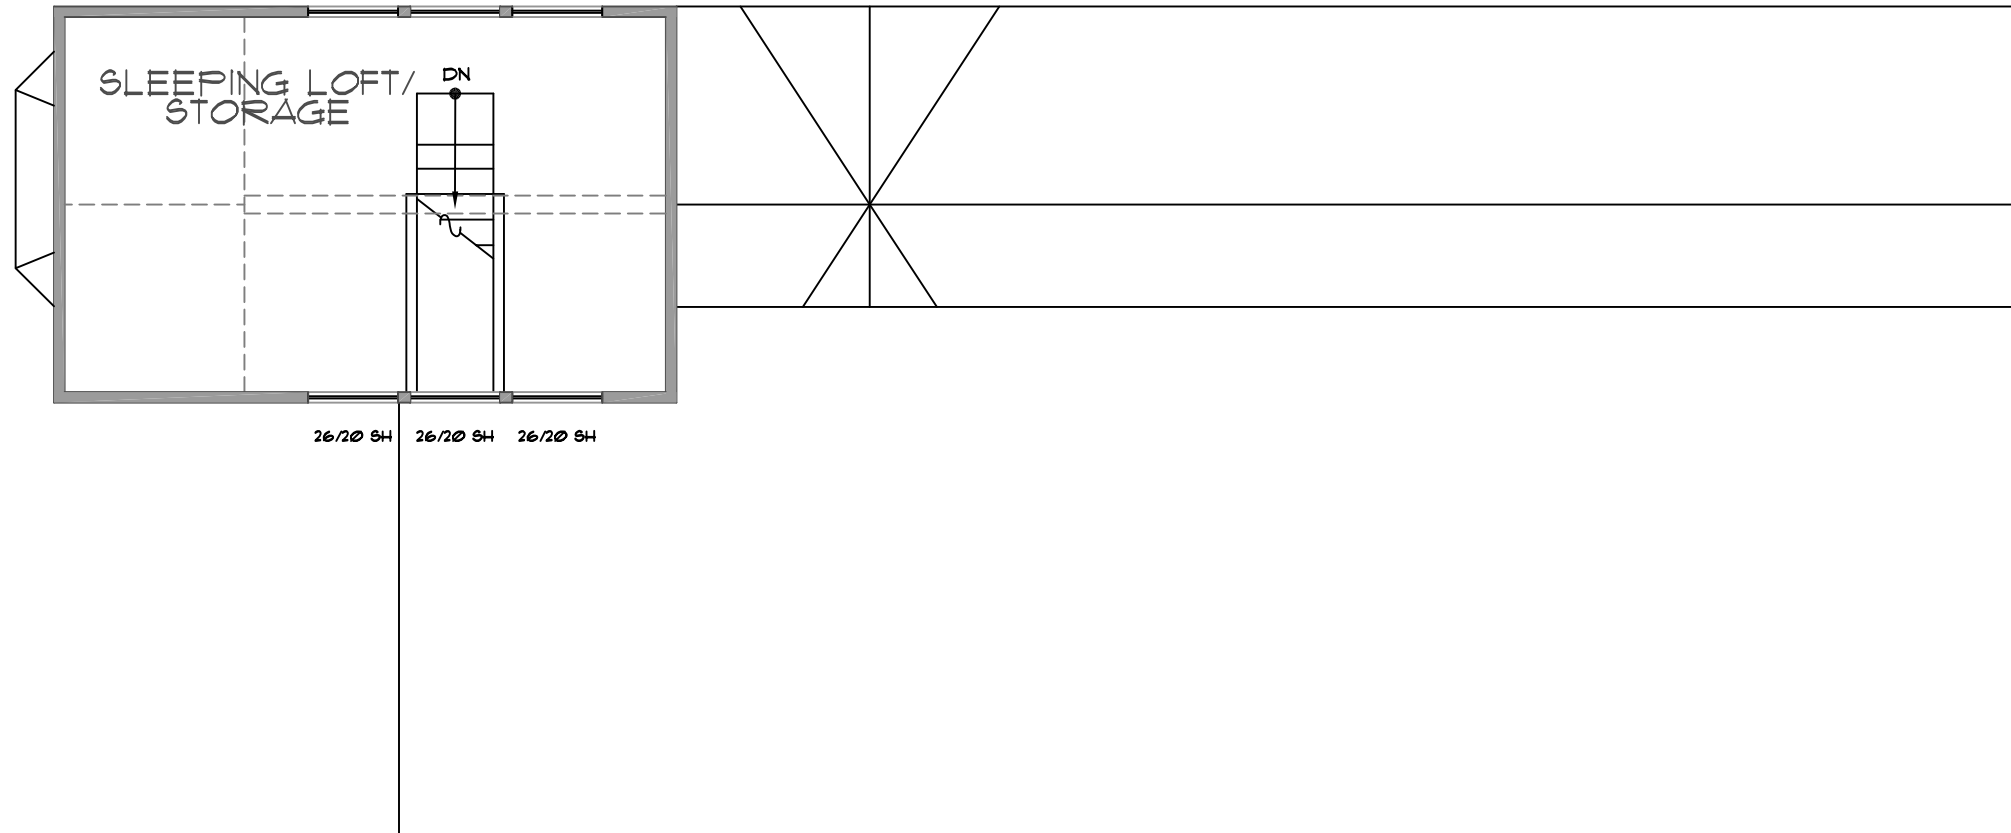

OZ - SITE 410 - AS-BUILT 2ND FLOORPLAN

1/4"=1'-0"

LOFT SECTION

1/4"=1'-0"

